



KEY-PLAN

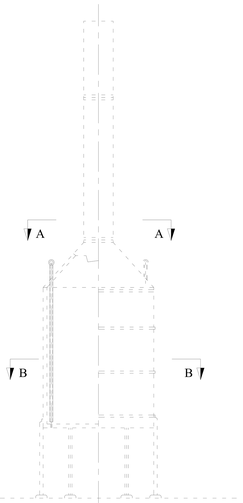


ELEVATION

(NOTE: REFER ONLY FOR REACTIVATION HEATER TUBES OTHER DETAILS ARE NOT SHOWN FOR CLARITY)

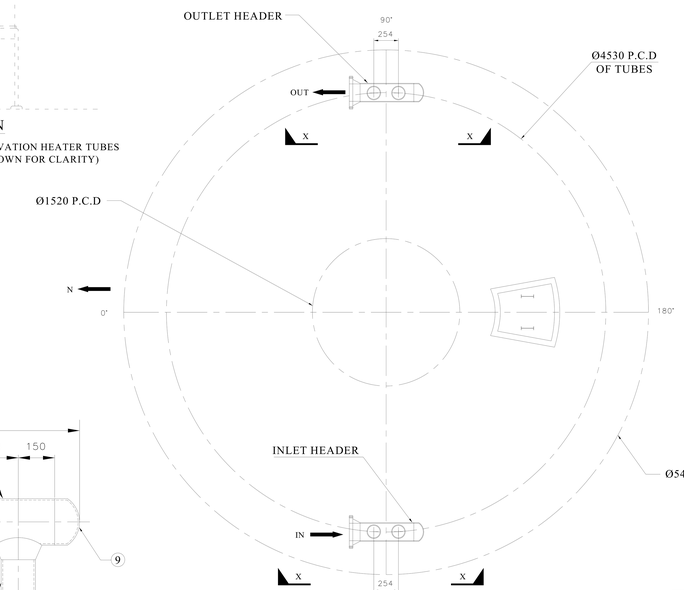


SECTION A-A

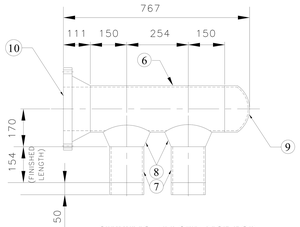

CUTTING ALLOWANCE FOR PRESSURE TESTING REMOVE AFTER TESTING AND RE-PREPARE END FOR WELDING.


VIEW X-X

(INLET/OUTLET HEADERS)

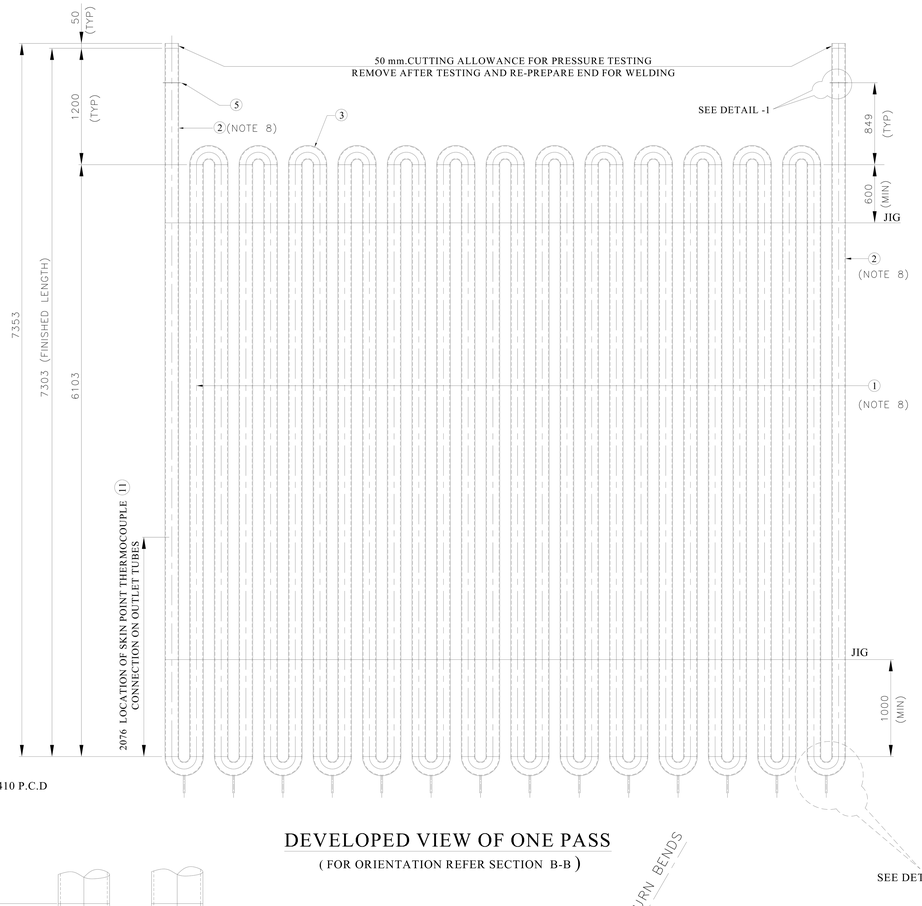


DEVELOPED VIEW OF ONE PASS

(FOR ORIENTATION REFER SECTION B-B)

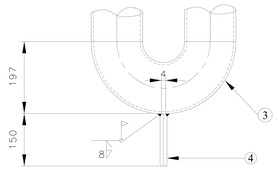


DETAIL - 3

(BOTTOM TUBE GUIDE PIN DETAILS.)

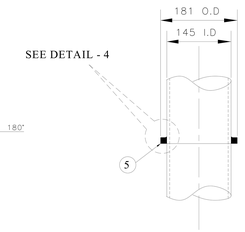


DETAIL - 1


(DETAIL OF SUPPORT RING FOR INLET AND OUTLET)

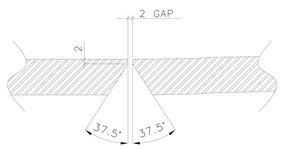

BUTT WELD DETAILS

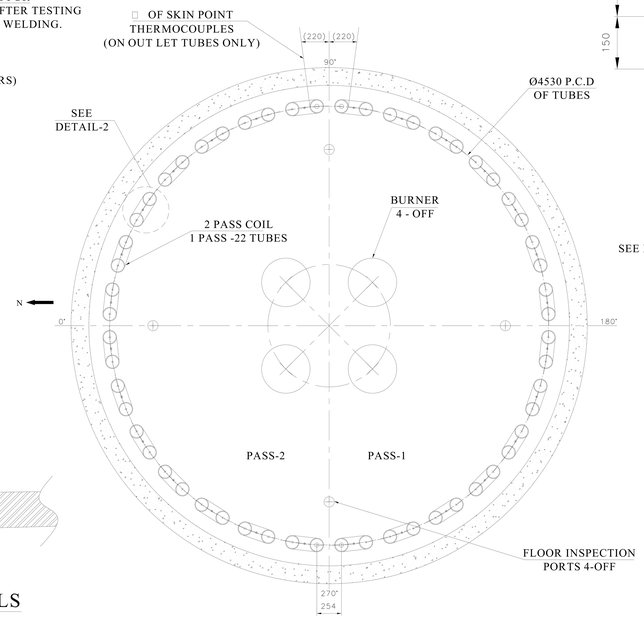


SECTION B-B

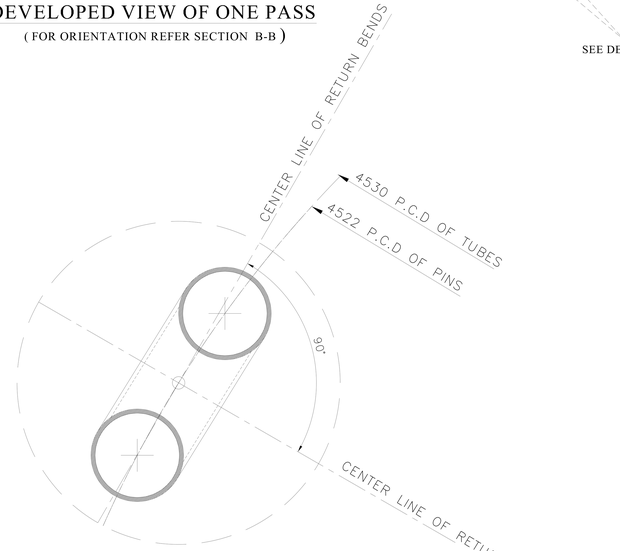

DETAIL - 2

NOTE :
(PIN ARE NOT LOCATED ON P.C.D OF TUBES.)

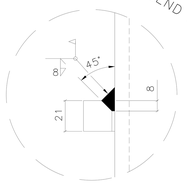

DETAIL - 4

DESIGN CONDITIONS:

NORMAL WORKING PRESSURE		NORMAL WORKING TEMPERATURE	
INLET	OUTLET	INLET	OUTLET
24 BARS ABS.	23.068 BARS ABS.	23.9°C	315.6°C
DESIGN PRESSURE : 25.3 BARG. PNEUMATIC TEST PRESSURE : 27.83 BARG.		DESIGN TEMPERATURE : 431°C	

GENERAL NOTES:

1. FABRICATION AND INSPECTION TO ASME B31.3
2. STRESS RELIEF : YES (ALL PIPE TO ELBOW BUTT WELD)
3. RADIOGRAPHY : YES (ALL BUTT WELDS)
4. DYE PEN. CHECK : YES (ALL FILLET WELDS)
5. PNEUMATIC NITROGEN TEST PRES : 27.83 BARG.
6. INSULATION : EXCLUDED
7. ALL DIMENSIONS ARE IN MM.
8. ALL CUTTING & SHAPING OF TUBES TO BE DONE BY MACHINE METHOD.FLAME CUTTING IS NOT ALLOWED IN ANY INSTANCE.
9. GUIDE PIN NUTS & WASHERS ARE TO BE REMOVED BEFORE COMMISSONING.
10. COIL TO BE SUPPLIED WITH NITROGEN PRESERVATION AT 10 PSI WITH ONE PRESSURE GAUGE& ONE VALVE
11. PAINTING : NONE
12. SKIN POINT THERMOCOUPLE IS IN DOLPHIN SCOPE (2NOS PER COIL)
13. ADGAS SOURCE DRAWING NO.A-3-A1F-1-12607

ASBUILT

ITEM	SIZE	DESCRIPTION	QTY.
11		SKIN POINT THERMOCOUPLE	2
10	8"NB	FLANGE A182-F5 300# WNRF SCH.XS/80	2
9	8"NB	CAP A234-WP5 CLASS-1 SCH.XS/80 BE SMLS	2
8	5".NB x	8"NB WELDOLET A182-F5 SCH.XS/80 BE	4
7	5.563"OD	TUBE A213-T5 SMLS ¼" MIN.THK.BE 204 Lg.	4
6	8"NB	PIPE A335-P5 SMLS SCH.XS/80 BE	1.2M
5	21mm	THK.x181 ODx145 ID.SUPPORT RING A387 Gr.5 (MACHINED FROM 25 THK.PLATE)	0.16M²
4	¾"	DIA BOTTOM TUBE GUIDE PIN,SS321	4.5M
3	5.563"OD	RETURN BEND 180° SR A234-WP5 CLASS-1 SMLS ¼"MIN.THK.BE	54
2	5.563"OD	TUBE A213-T5 SMLS ¼" MIN.THK.BE 7353 Lg.	4
1	5.563"OD	TUBE A213-T5 SMLS ¼" MIN.THK.BE 6103 Lg.	52

BILL OF MATERIALS TOTAL WT.= Kg

REV	DATE	DESCRIPTION	DRN.	CH.	ENG.	APP.	APP. ADGAS
2	20-03-12	ASBUILT	CGN	SM	SM	SM	
1	21-06-11	ISSUED FOR CONSTRUCTION	SKS	SM	SM	SM	
0	14-04-11	ISSUED FOR APPROVAL	SKS	SM	SM	SM	

ABU DHABI GAS LIQUEFACTION COMPANY LIMITED (ADGAS)

PROJECT : REPLACEMENT OF HEATER COIL FOR TRAIN II

DOLPHIN HEAT TRANSFER L.L.C
P.O. Box 20678. Plot No. 105, New Industrial Area.
Ajman, U.A.E. Tel: 06-7482504, Fax: 06-7482506.
Email: dolheat@emirates.ae Web: www.dolphinheattransfer.com

CONTRACTOR DRAWING NO: DHT-11772-001

TITLE: DETAILS OF HEATER COIL FOR ITEM No. 3-F-0201

ADGAS PO. No. 4500041641-B9

MOD NO. SD/2/007/10

DRAWING NUMBER AC-3-A1F-2-14803

REV. 2

SCALE: 1:25

CAD FILE NO. AC-3-A1F-2-14803-0001.DWG